

Possible  
Record  
ONLY

? 2052 Spring Rd?

DEPARTMENT OF PUBLIC HEALTH - SEWAGE RECORD

Construction Permit Number

HALL  
County

4-11-73  
Date Completed

MANDY DAY  
Owner's Name

SPRING Rd  
Road Subdivision & Lot Number

Howard Lee  
Contractor's Signature

Rt 4# Gainesville, GA.  
Address

WATER SUPPLY: Public  Individual

NUMBER OF FIELD LINES 5

HOUSE STRUCTURE: New  Existing

TOTAL LENGTH: 140 feet

TYPE OF FACILITY RESIDENTS

WIDTH OF TRENCH: 36 inches

SEWAGE INSTALLATION: New  Existing

DEPTH OF TRENCH: 30 inches

NUMBER OF BEDROOMS: 2 Gallons

DISTANCE FROM FOUNDATION: 5 feet

BUILDING LINE FROM ROAD: 70

NEAREST PROPERTY LINE: 10 feet

LOT SIZE: Depth: 150 Width: 100

DISTANCE FROM WELL: \_\_\_\_\_ feet

SEPTIC TANK CAPACITY: 750

FILTER MATERIAL: Size 5" Depth 2 FT


DISTANCE TANK FROM WELL: \_\_\_\_\_

SHOW LOCATION BELOW OF: facility, septic tank, field lines, well, spring, or public water line, nearest lot line, drive way, and distribution box, dosing tank and pump (if used)

-----  
Represents field line

\_\_\_\_\_ Represents solid line and sewers

SKETCH

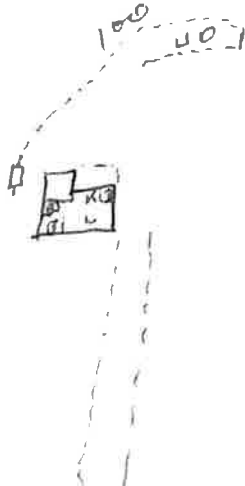

Received 4/21/73  
H. W. Walker

SPRING Rd. ROAD

AS BUILT PLOT PLAN