


~~RECORD~~

PISTON FIZZ
CARTOON ACT
OPEN TOP FOUND
MAIL BOX FOUND
MAIL BOX SET
JUNCTION BOX
POWER LINE
LIGHT POLE
PROPERTY LINE
PIPE
CHAR LIA TONCE
SEWERS CLEAN OUT
SEWERS CATCHBASIN
DROP INLET
RIGHT-OF-WAY
SANITARY SEWER EASEMENT
SECTION 307 ZONE
UTILITY CASSIDON
FIRE HYDRANT
SEWERS CATCHBASIN
DOUBLE WING CATCHBASIN
WATER VALVE
WATER VALVE
HEADWALL

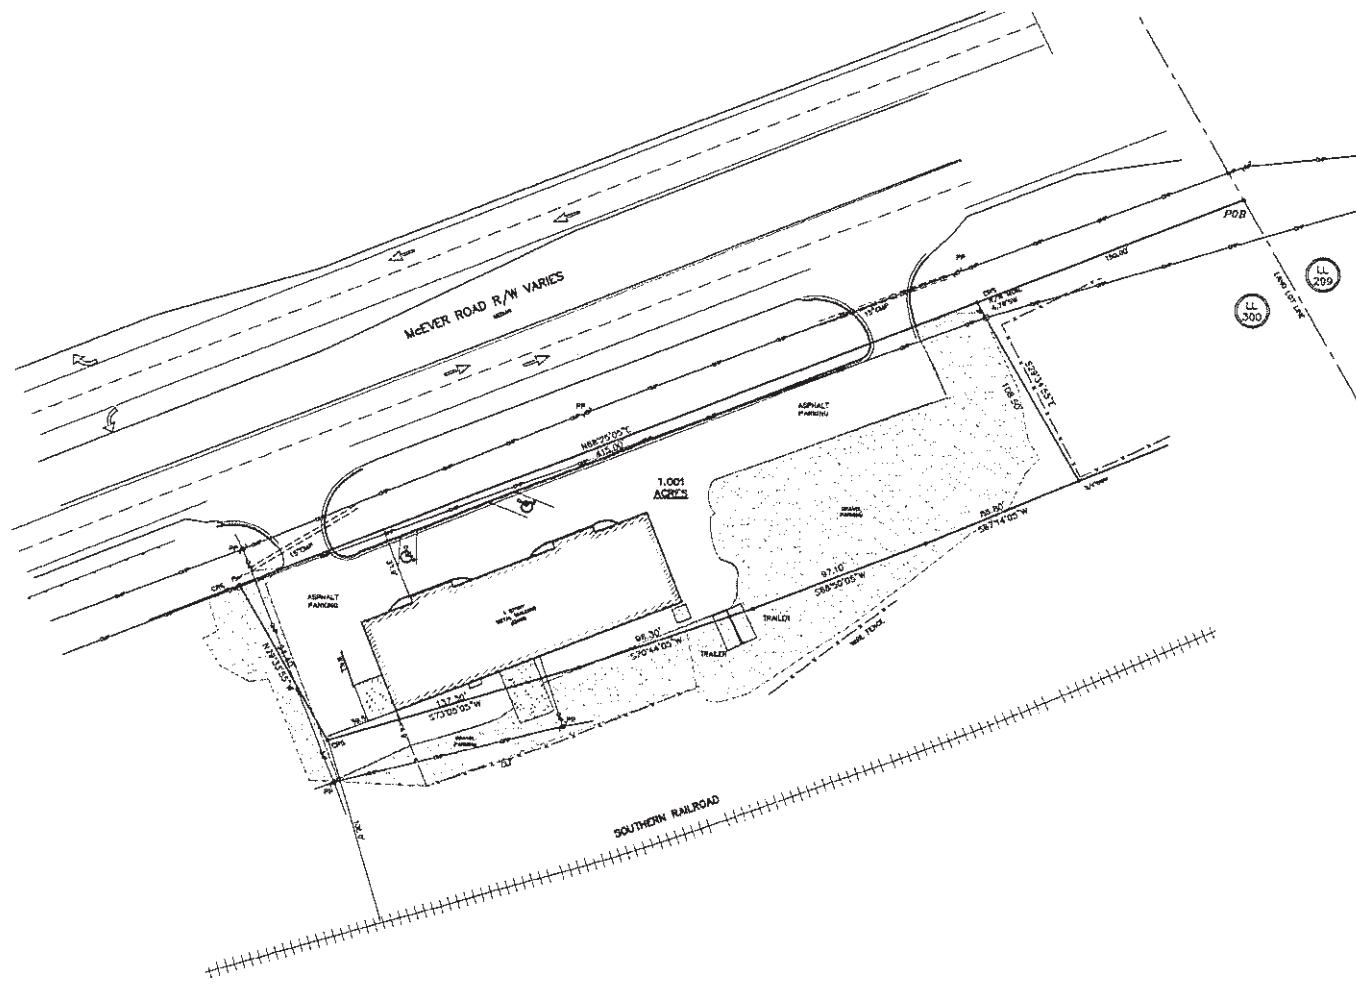

GENERAL NOTES
 THIS PLAT HAS BEEN CALCULATED FOR CLERICAL USE ONLY AND IS NOT TO BE USED AS A RECORD DOCUMENT TO WHICH ONE POST IN ELGIN PLAT.
 THE FIELD CALL UPON WHICH THIS PLAT IS MADE IS LOCATED ON THE PROPERTY OWNED IN ELGIN POST AND AN ADDITIONAL PROPERTY OWNED IN ELGIN POST AND THE ASSOCIATED LAND COMPANY PLAT.

A ROAD - TOTAL KARDO AND USED TO DETERMINE THE LINES OF THE PROPERTY LINE OF THIS PLAT.

PROPERTY OWNED BY PLANO AREA HIGH SCHOOL DISTRICT FROM HOUSE TO STREETLINE.

PROPERTY OWNED BY LOCAL AUTHORITY OF ELGIN MUNICIPAL UTILITY AUTHORITY, UNITED STATES GOVERNMENT, THAT IS OWNED BY THE LOCAL AUTHORITY FOR THE COMPLETION OF THE PROJECT.

THIS PROPERTY IS SUBJECT TO ALL RIGHS OF WAY, EASEMENTS, AND OTHER RESTRICTIONS OF ANY NATURE, WHETHER EXISTING OR IMPOSED.

FLOOD NOTES:
 BASE FLOOD ELEVATION INFORMATION
 THIS PROPERTY DOES NOT USE FLOOD A-ZONE/FLOOD HAZARD AREA INFORMATION.
 A FLOOD HAZARD MAP IS MAILED TO THE PROPERTY OWNER.
 DRAWN ON 05/06/2025
 DRAWN BY: JEFFREY T. COOPER
 DRAWN DATE: 05/06/2025
 DRAWN BY: JEFFREY T. COOPER
 DRAWN DATE: 05/06/2025

SCI Development Services
 ENGINEERS • SURVEYORS • PLANNERS
 2020 WESTSIDE COURT • SUITE E • SNELLVILLE, GEORGIA 30078
 (770) 734-7446 • FAX (770) 734-4423
 WWW.SCI-DEVELOPMENT.COM

Auto World of Atlanta, Inc
 5005 EASTERLY ROAD
 LAND LOT NO. 100
 CITY OF BUCKHEAD
 HALL COUNTY, GEORGIA
 FEE IN DR. 7092, PG. 645

ASBUILT SURVEY
 PROJECT NUMBER: 5005
 DATE: 05/06/2025
 SURVEYOR: JEFFREY T. COOPER
 DRAWN DATE: 05/06/2025

A-1