


eFiled & eRecorded
DATE: 4/13/2020
TIME: 8:33 AM
PLAT BOOK: 00878
PAGE: 00346
RECORDING FEES: \$10.00
PARTICIPANT ID: 9658393969
CLERK: Charles Baker
Hall County, GA
NOTE: by ch 6 of 21

THIS BOX RESERVED FOR
THE CLERK OF THE SUPERIOR COURT

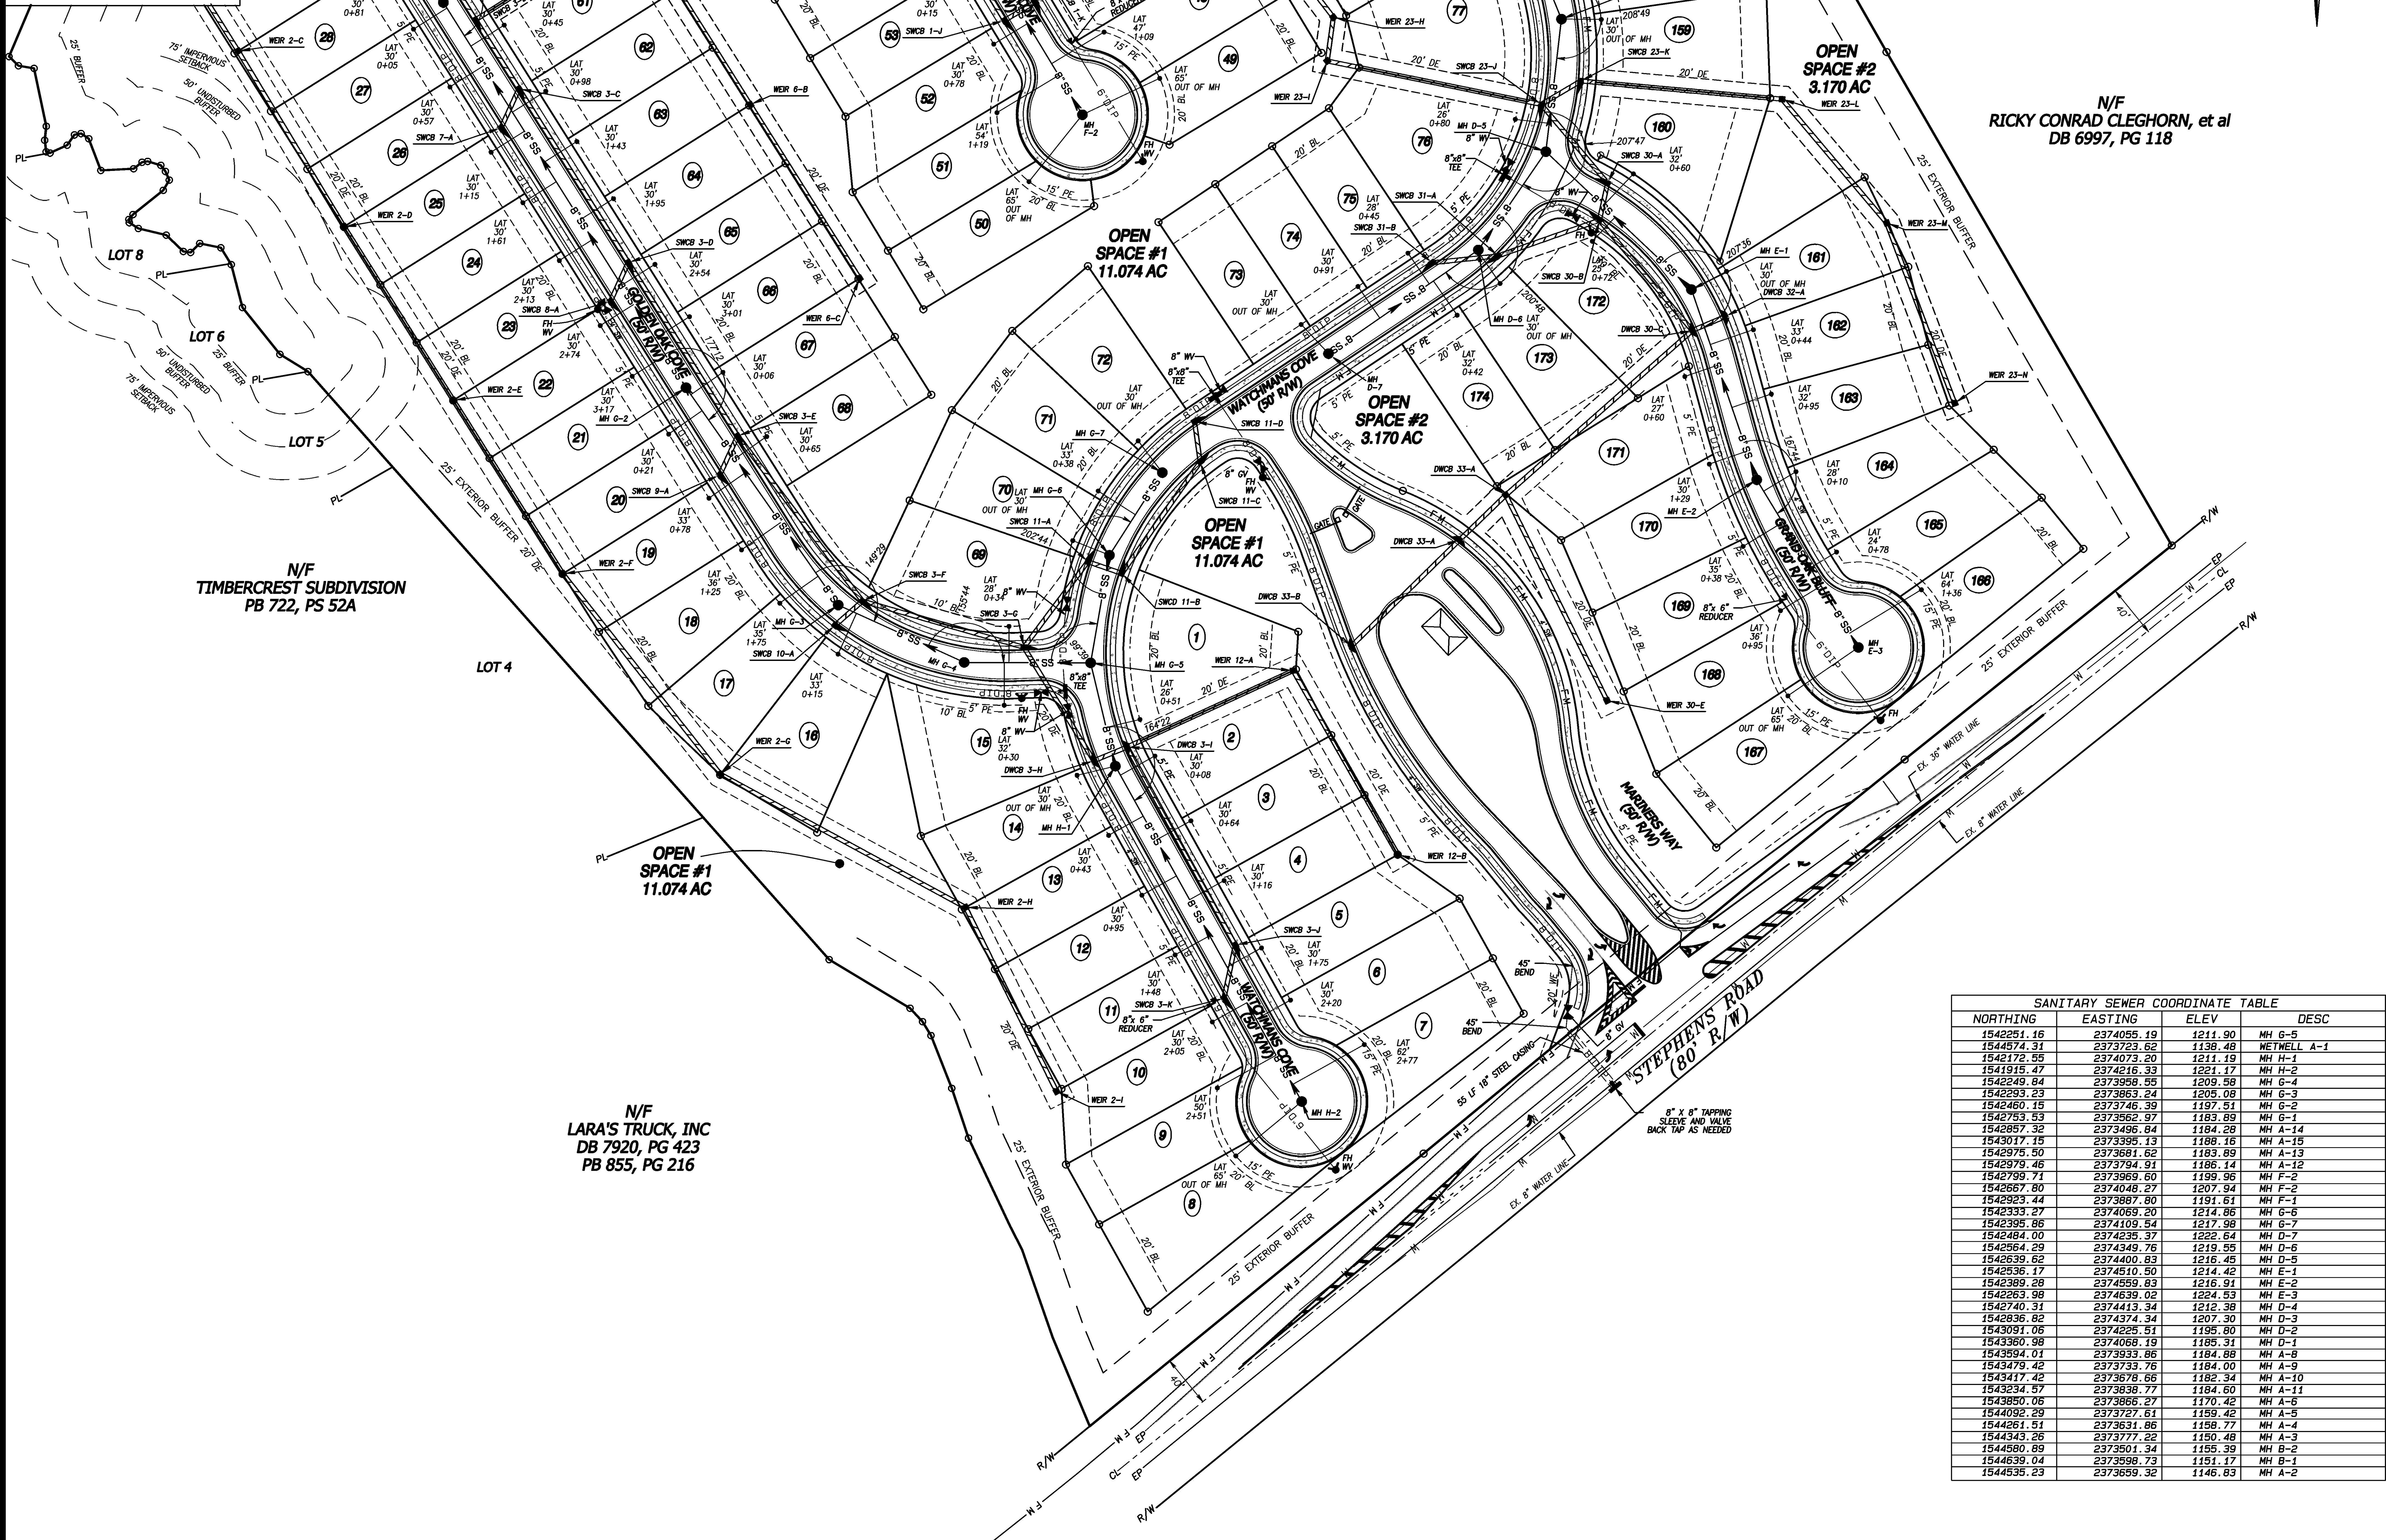


N/F
RICKY CONRAD CLEGHORN, et al
DB 6997, PG 118

Rochester & Associates, Inc.
425 Oak Street N.W. • Gainesville, Georgia 30501
(770)718.0600 (770)718.9050 Fax • www.rochester-assoc.com

STORM, SANITARY SEWER AND WATER AS-BUILTS
FOR :
STEPHENS POINT
PHASE 1
LOCATED IN
LAND LOTS 64 & 65
8TH DISTRICT
HALL COUNTY, GEORGIA

NO.	DATE	DESCRIPTION	REVISIONS
1	02/05/20	SEE REVISION NOTE #1, SHEET #1	
2	09/25/19	ADRESSED HALL COUNTY COMMENTS	
3	09/25/19	ADRESSED HALL COUNTY COMMENTS	

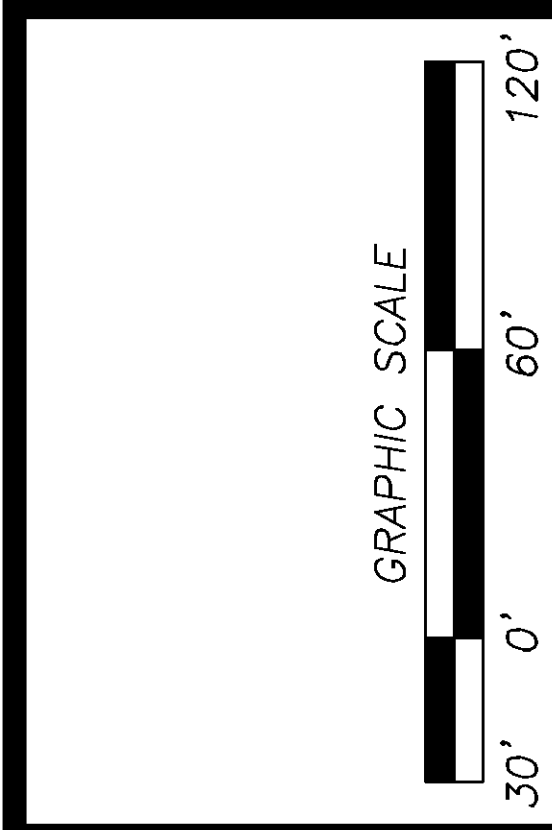

SHEET
6
OF
21
DATE : 9/16/19
SCALE : 1" = 60'
JOB NO : 0217126LNR
FILE NO. : #FNL01
DRAWN BY: WDC

SANITARY SEWER COORDINATE TABLE			
NORTHING	EASTING	ELEV	DESC
1542251.16	2374055.19	1211.90	MH 6-5
1544574.31	2373723.62	1138.48	WETWELL A-1
1542172.95	2374073.20	1211.19	MH H-1
1541915.47	2374215.33	1221.17	MH H-2
1542249.84	2373559.55	1209.58	MH G-4
1542293.23	2373863.24	1205.08	MH G-3
1542460.15	2373746.39	1197.51	MH G-2
1542753.53	2373562.97	1183.89	MH G-1
1542687.80	2373495.84	1184.28	MH A-14
1543017.15	2373395.13	1188.16	MH A-15
1542975.50	2373681.62	1183.89	MH A-13
1542979.46	2373794.91	1186.14	MH A-12
1542799.71	2373969.60	1199.96	MH F-2
1542687.80	2374048.27	1207.94	MH F-2
1542923.44	2373887.80	1191.61	MH F-1
1542333.27	2374069.20	1214.86	MH G-6
1542395.86	2374109.54	1217.98	MH G-7
1542484.00	2374235.37	1222.64	MH D-7
1542654.29	2374349.76	1219.55	MH D-6
1542639.62	2374400.83	1216.45	MH D-5
1542536.17	2374510.50	1214.42	MH E-1
1542389.28	2374559.83	1216.91	MH E-2
1542263.98	2374639.02	1224.93	MH E-3
1542740.31	2374413.34	1212.38	MH D-4
1542836.82	2374374.34	1207.30	MH D-3
1543091.06	2374225.51	1195.80	MH D-2
1543360.98	2374068.19	1185.31	MH D-1
1543954.01	2373933.86	1184.88	MH A-8
1543479.42	2373733.76	1184.00	MH A-9
1543417.42	2373678.66	1182.34	MH A-10
1543234.57	2373838.77	1184.60	MH A-11
1543850.06	2373866.27	1170.42	MH A-6
1544092.29	2373727.61	1159.42	MH A-5
1544261.51	2373631.86	1158.77	MH A-4
1544343.26	2373777.22	1150.48	MH A-3
1544580.89	2373501.34	1155.39	MH B-2
1544639.04	2373598.73	1151.17	MH B-1
1544535.23	2373659.32	1146.83	MH A-2