



September 9, 2025

Bill Nash, Director of Public Works & Utilities
Community Development and Infrastructure
2875 Browns Bridge Rd
Gainseville, Georgia 30504

RE: **PI# L13220**
White Sulphur @ SR 365

Mr. Nash,

Attached is a copy of the New Relocation Agreement between Georgia Power Company and Hall County for the above referenced project.

Please sign and return the copy to the email address below:

Georgia Power Company
Jalexis Susana
X2jsusan@southerncompany.com

After it has been executed by Georgia Power Company we will email you a copy.

Both the total estimated cost for relocation and the Payment Amount are valid only for a period of one (1) year following the date set forth on the enclosed estimate. Further, Georgia Power will not commence any work unless, the County executes and returns the enclosed Relocation Agreement and authorizes commencement of the work. Work must commence within 6 months of the executed relocation agreement.

If you have any questions, please contact Stephen Burroughs at 470-895-3122.

Sincerely,

A handwritten signature in cursive script that reads "Jalexis Susana".

Jalexis Susana
mrkimber@southernco.com

Attachments

Please sign the agreement and send the electronic copy to the email address below:

Jalexis Susana (x2jsusan@southernco.com)

After the agreement has been executed by Georgia Power Company, we will email a copy to you for your records.

Please remit any payments to the address below:

Georgia Power Company

96 Annex

Atlanta, GA 30396-0001

(Attn: Salanda Westry)

Please reference the invoice and or PI# number on the check.

UTILITY RELOCATION AGREEMENT

PROJECT NAME: White Sulphur @ SR 365

PROJECT NUMBER: L13220

GDOT PROJECT NUMBER: _____

THIS AGREEMENT is made and entered into as of the ____ day of _____, 20____ by and between **HALL COUNTY**, State of Georgia (hereinafter referred to as the "County"), and **GEORGIA POWER COMPANY** (hereinafter referred to as the "Company"). This Agreement may refer to either County or Company, or both, as a "Party" or "Parties."

WITNESSETH:

WHEREAS, the County proposes under the above written Project to White Sulphur @ SR @ 365 (hereinafter referred to as the "Project"); and

WHEREAS, due to the construction of the Project, it will become necessary for the Company to remove, relocate or make certain adjustments to the Company's existing facilities (such facilities, including but not limited to overhead and underground electric transmission, distribution and communication lines, towers, frames, poles, facilities, wires, transformers, service pedestals, apparatus, manholes, conduits, fixtures, appliances, cables, protective wires and devices all being hereinafter referred to collectively as the "Facilities" or individually as the "Facility"); and

WHEREAS, the Company, as hereinafter provided, may assert that it has certain property interests and rights and utilized such property interests and rights for the placement of its Facilities prior in time to County's acquisition of the road right(s)-of-way, all as involved in said Project; and

NOW, THEREFORE, in consideration of the promises and the mutual covenants of the Parties hereinafter set forth and other good and valuable consideration, the receipt and sufficiency of which are hereby acknowledged by the Parties, the Parties agree as follows:

Section 1 **THE WORK**

1.1 **Company Facilities**

Company, with its regular construction or maintenance crews and personnel, at its standard schedule of wages and working hours (as may be applicable from time to time during the term of this Agreement), and working in accordance with the terms of its agreements with such employees, will remove, relocate or make adjustments to its Facilities in accordance with the scope of work and Estimate (defined below) attached hereto as Exhibit "A" and incorporated herein by reference (the "Work"). Company shall make all technical decisions concerning the Work and may elect to contract any portion of the Work.

1.2 Road Right-of-Way

Prior to Company commencing the Work, County will provide written assurances to Company that it has acquired the necessary new road right-of-way (including information on the property rights acquired).

1.3 Traffic Control

Company shall make a reasonable effort to provide signing and other traffic control measures during the Work, in accordance with PART VI of the U. S. Department of Transportation Manual on Uniform Traffic Control Devices, current edition, all at the expense of the County.

Section 2 COSTS AND PAYMENT

2.1 Compensable Property Interests.

Company shall perform the Work in accordance with the estimate attached hereto as Exhibit "A" and incorporated herein by reference (the "Total Estimate"). The total amount of the Total Estimate is SEVEN HUNDRED FORTY-FOUR THOUSAND AND TWO HUNDRED TWENTY-SEVEN Dollars (\$744,227.00). The amount of the Total Estimate that corresponds to Company's claim that it has compensable property interests with respect to the Project (the "Reimbursement Claim") is SEVEN HUNDRED FORTY-FOUR THOUSAND AND TWO HUNDRED TWENTY-SEVEN Dollars (\$744,227.00), otherwise reflected as **ONE HUNDRED percent (100%)** of the Total Estimate. The Reimbursement Claim is limited to: (a) the costs of removing, relocating or adjusting those Facilities which are physically in place and in conflict with the proposed construction and/or maintenance; (b) where replacement is necessary, the costs of replacement in kind, and any improvements or betterments made necessary by the proposed construction and/or maintenance; and (c) the costs incurred in acquiring additional easements or private rights-of-way, including without limitation easements for lines, access, tree trimming, guy wires, anchors and other devices, appliances and other equipment, and any and all other such easements and property rights as may be reasonably necessary for the Company's installation, operation and maintenance of its Facilities (collectively, the "Relocation Costs").

The cost of any improvements or betterments that are not made necessary by the proposed construction or maintenance shall not be subject to the percentage split contemplated above. Such costs shall be paid as follows: (a) the costs of any improvements or betterments of a Facility being made solely at Company's option (and not being made necessary by the proposed construction and/or maintenance) shall be fully paid by Company; and (b) the costs of any improvements or betterments of a Facility being made solely at County's request (and not being made necessary by the proposed construction and/or maintenance) shall be fully paid by County.

Upon completion by Company of the Work and subject to determination of Company's Prior Rights Claim in accordance with Sections 3 and 4 below, County will pay Company a sum equal to the lesser of (a) SEVEN HUNDRED FORTY-FOUR THOUSAND AND TWO HUNDRED TWENTY-SEVEN Dollars (\$744,227.00), otherwise reflected as **ONE HUNDRED percent (100%)** of the Total Estimate and representing the aforementioned Reimbursement Claim, or (b) the corresponding percentage of actual Relocation Costs representing Company's compensable property interests with respect to the Project. County will also pay Company for the

costs of any improvements or betterments of a Facility being made solely at County's request and not being made necessary by the proposed construction and/or maintenance.

2.2 Progress Payments

If Company chooses to submit invoices for progress payments, County will pay same within thirty (30) days from receipt of the invoice, subject to Verification (as defined below) thereof by the County. Upon completion of the Work, Company shall submit a final bill to County and County shall make a final payment within thirty (30) days from receipt of the final bill, subject to Verification thereof by the County.

2.3 Change in Scope

In the event there is a change in the Project, including without limitation a change in scope, design, plans, service, property interests to be acquired, engineering or costs, due to either (a) events or circumstances beyond Company's reasonable control, or (b) County's request, the Parties will negotiate in good faith a mutually acceptable agreement or amendment to this Agreement, in writing, to address such change and any increase in costs above those set forth in the Estimate.

Section 3 DETERMINATION OF COMPENSABLE PROPERTY INTEREST

3.1 If Company determines it has compensable property interests with respect to the Project, Company will submit a Reimbursement Claim. The Parties agree that they will in good faith share non-privileged information with each other related to the issue of prior rights for the Project. If County determines that Company's evidence is insufficient to make a determination as to Company's compensable property interests and the percentage of the Relocation Costs to be paid by Company based upon such compensable property interests, County will provide Company with a written basis for such insufficiency and request that Company provide additional information. County will make a determination as to any asserted Reimbursement Claim before the earlier of: (a) the date that is thirty (30) days after receipt of the Reimbursement Claim; and (b) the date on which Company needs to commence the Work in order to prevent a Project delay (the "Commencement Date").

3.2 In the event that a determination cannot reasonably be made prior to the Commencement Date, provided that County certifies in writing to Company that the Project is time-sensitive due to construction scheduling with the possibility of damages for delay, safety concerns, or critical funding deadlines, Company will commence the Work without a written determination having been made. In such case, the Party's rights, claims and defenses with regard to the issue of compensable property interests and prior rights will not be waived or affected in any manner. If County does not thereafter make a determination regarding the Reimbursement Claim within six (6) months from the date of County's receipt of same, the Reimbursement Claim will be deemed approved by County.

Section 4 **DISPUTE RESOLUTION**

4.1 **Disagreement**

If Company disagrees with County's determination with regard to the Reimbursement Claim and the Parties are unable to settle the issue through informal negotiations, then, at the request of either Party, the Parties agree to escalate the matter pursuant to Section 4.2 below.

4.2 **Dispute Notice**

Except as otherwise set forth in this Agreement, any controversy or claim arising out of or relating to this Agreement, or the breach thereof, will be settled: (a) first, by good faith efforts to reach mutual agreement of the Parties; and (b) second, if mutual agreement is not reached within thirty (30) calendar days of a written request by a Party to resolve the controversy or claim (the "Dispute Notice"), each of the Parties will appoint a designated representative who has authority to settle the dispute (or who has authority to recommend to the governing body of such Party a settlement of the dispute) and who is at a higher level of management than the persons with direct responsibility for administration of this Agreement. The designated representatives will meet as often as they reasonably deem necessary in order to discuss the dispute and negotiate in good faith in an effort to resolve such dispute. The specific format for such discussions will be left to the discretion of the designated representatives, provided, however, that all reasonable requests for relevant information made by one Party to the other Party will be honored if such information is reasonably available. If within sixty (60) days after issuance of a Dispute Notice (a) the Parties are unable to resolve issues related to the dispute, or (b) County fails to approve any tentative agreement reached, the Parties agree to participate in confidential, non-binding mediation pursuant to Section 4.3 below, it being understood, however, that nothing herein will diminish or relieve either Party of its rights or obligations under this Section 4.

4.3 **Mediation**

If the Parties are unable to resolve a dispute through informal negotiations or pursuant to Section 4.2, the Parties agree to participate in confidential, non-binding mediation by an impartial, third party mediator mutually agreed upon by the Parties, at a mutually convenient location. The Parties agree that a potential mediator's experience in prior rights and real estate law will be relevant factors in selecting a mediator. In the event the Parties are unable to agree on a third party mediator within ninety (90) days of issuance of the Dispute Notice, each Party shall designate a mediation representative, and the two mediator representatives shall in good faith select a third party mediator. Each Party shall be responsible for its own attorneys' fees and expenses and for providing its own information and documentation applicable to the dispute to the mediator. All other agreed upon costs of the mediation will be apportioned equally to each Party. Any dispute not resolved by negotiation, escalation or mediation may then be submitted to a court of competent jurisdiction, and either Party may invoke any remedies at law or in equity. Nothing contained herein, however, will preclude the Parties from first seeking temporary injunctive or other equitable relief. The Parties agree that any statute of limitations, equity or other time-based periods shall be tolled as of and from the date of the Dispute Notice until a complaint, if any, is filed.

Section 5 **VERIFICATION**

5.1 **Material Discrepancy**

For purposes of this Section 5, “Verification” means that County has reasonably determined that there is a material discrepancy between Company’s invoiced charges and County’s calculation of charges owed, which invoiced charges are subject to a bona fide dispute; provided, however, County agrees to provide the Company with written notice, including supporting documentation, illustrating the basis for such bona fide dispute, within sixty (60) days of receipt of the invoice in dispute. Should County fail to provide such documentation within the specified time period, County must pay the disputed amount. County must pay any undisputed portion of the invoice total within thirty (30) days after its receipt of the invoice. County must pay any disputed portion of the invoice total within thirty (30) days of the date the dispute is resolved, to the extent the dispute is resolved in favor of Company.

5.2 **Audit**

At any time within thirty-six (36) months after the date of final payment, County, at its sole expense, may audit the non-privileged cost records, support documentation and accounts of Company pertaining to this Project to solely assess the accuracy of the invoices submitted by Company and notify Company of any amount of any unallowable expenditure made in the final payment under this Agreement, or, if no unallowable expenditure is found, notify Company of that fact in writing. Any such audit will be conducted by representatives of County or, if applicable, the Georgia Department of Transportation or the Federal Highway Administration, after reasonable advance written notice to Company and during regular business hours at the offices of Company in a manner that does not unreasonably interfere with Company’s business activities and subject to Company’s reasonable security requirements. As a prerequisite to conducting such audit, County or, if applicable, the Georgia Department of Transportation or the Federal Highway Administration, will sign Company’s Nondisclosure Agreement. Company may redact from its records provided to County information that is confidential and irrelevant to the purposes of the audit. Company will reasonably cooperate in any such audit, providing access to Company records that are reasonably necessary to enable County to test the accuracy of the invoices to which the audit pertains, provided that County or, if applicable, the Georgia Department of Transportation or the Federal Highway Administration, may only review, but not copy, such records. If Company agrees with the audit results and does not pay any such bill within ninety (90) days of receipt of the bill from County (based on the mutually agreed upon audit results), County may set off the amount of such bill against the amounts owed Company on any then-current contract between Company and County. If, following the audit, the Parties are unable to resolve any dispute concerning the results of the audit through informal negotiation, the provisions of Sections 4.2 and 4.3 will govern the resolution of the dispute. County may not perform an audit pursuant to this Agreement more frequently than once per calendar year and may not conduct audits twice within any six (6) months.

Section 6 **COUNTY AS PARTY**

County acknowledges that this Agreement is “proprietary” in nature under applicable Georgia law, as permitted by O.C.G.A. § 36-60-13(j), and not “governmental” or “legislative,” as prohibited by O.C.G.A. § 36-30-3(a). County further represents and warrants that this Agreement will comply with all applicable laws concerning County actions and approvals and execution of binding agreements. County covenants to undertake all actions necessary to bind County.

Section 7 **COMMENCEMENT AND TERMINATION CONDITIONS**

Company is not obligated to commence the Work until Parties agree on the removal, relocation and/or adjustment to Company’s facilities required by the Project. If County fails to authorize commencement of the Work by September 9, 2026, Company will have no obligation to begin the Work and may terminate this Agreement without penalty by providing County with notice in writing. If County fails to sign and return this Agreement to Company September 9, 2026, any offer made by Company pursuant to the Agreement is automatically revoked and the agreement is void and of no effect.

Section 8 **MISCELLANEOUS PROVISIONS**

Duplicate originals of this Agreement will be executed, each of which will be deemed an original but both of which together will constitute one and the same instrument. This Agreement may be modified only by an amendment executed in writing by a duly authorized representative for each Party. This Agreement contains the entire agreement of the Parties, and all prior oral agreements are superseded and integrated into this Agreement. This Agreement will be governed by and construed in accordance with the laws of the State of Georgia. This Agreement shall accrue to the benefit of and be binding upon the successors and assigns of the Parties. The Parties agree that this Agreement shall be deemed to have been executed in Georgia.

[SIGNATURES ON THE FOLLOWING PAGE]

IN WITNESS WHEREOF, the Parties have executed this Contract in four (4) counterparts, each of which shall be deemed an original in the year and day first above mentioned.

ATTEST:

HALL County, GEORGIA

By: _____

By: _____

Title: _____

Chairman, Board of Commissioners

Witness: _____

(SEAL)

Notary: _____

(SEAL)

Recorded on the Minutes of the County Commission at Minute Book ____, Page ____.

ATTEST:

GEORGIA POWER COMPANY

By: _____

By: _____

Title: _____

Witness: _____

Date: _____

Notary: _____

(SEAL)

[Give proper title of each person executing Agreement. Attach seal as required.]

SEQ. NO. 60-860Name of Line LE 6-635

Account No. _____

EASEMENT

Athens Division

Tabbitown-White Sulphur Road Line

2887-249 - LOT 47-1349

5465-63

STATE OF GEORGIA,

HALL COUNTY.Received of GEORGIA POWER

Company, hereinafter called the Company, the sum of

ONE & 00/100Dollars (\$ 1.00), in consideration of whichthe undersigned, S. I. BAUGH

(Name)

, whose Post Office Address is

GAINESVILLE, GA- RT-6

, do.c.s. hereby grant and convey to the said Company, its successors and

assigns, the right-of-way upon, along and across all that tract of land owned by the undersigned in Land Lot

Number _____ of the GAINESVILLE District, _____ Sectionof HALL County, State of Georgia, said lands being bounded on the Northby land of MRS. GRACE WILSON, on the South by lands ofAIR LINE SCHOOL, on the East by lands of ARTHUR BELL & BASEHULSEY, and on the West by lands of L. P. PITTMAN;

together with the right, privilege and easement to go in and upon the said tract of land and to construct, operate and maintain perpetually upon said right-of-way its lines for transmitting electric current, with poles, wires and other necessary apparatus and appliances, including the right to stretch telephone and/or telegraph wires on said poles, with all necessary appliances, with the right to permit the attachment of the wires of any other company, or person, to said poles and appliances; together with the right at all times to enter upon said premises for the purpose of inspecting said lines, making repairs, renewals, alterations and extensions thereon, thereto or therefrom; together with the right to cut away and keep clear of said lines all trees and other obstructions that may now or hereafter in any way interfere or be likely to interfere with the proper operation of said lines. Any timber cut on said right-of-way by or for said Company shall remain the property of the owner of said timber.

ALSO THE RIGHT TO ERECT SAID LINE ACROSS MY OTHER PROPERTY, SAME BEING IN THE GAINESVILLE DISTRICT, HALL COUNTY, GEORGIA & BEING MY HOME PLACE-

Said Company shall not be liable for, or bound by, any statement, agreement or understanding not herein expressed.

IN WITNESS WHEREOF, the said S. I. BAUGH

has

hereunto set his hand and seal, this 8th day of SEPT-, 1937.

S. I. Baugh (SEAL)
MARK (SEAL)

Signed, sealed and delivered in the presence of:

Mrs. A. E. WadsworthC. M. GoudDEED BOOK 77PAGE 219

GAINESVILLE-CORNELLIA HIGHWAY RURAL LINE

Hall County

HALL COUNTYLand Dept.
File No.Rabbit Holes - white Sulphur
ext.

5465-30	Will Sumner	
5465-31	W. D. Marchbanks	5465-31-1 Modane Marchbanks
5465-32	Mrs. B. B. Marchbanks	5465-31-2 A. B. Clark, Jr.
5465-33	Henry H. Estes	5465-31-3 Ralph Miller
5465-34	H. O. Hawkins	5465-31-4 Emory Broom
5465-35	Mrs. Pearl Barton	5465-31-5 L. B. Adams
5465-36	W. A. Jones	5465-31-6 Walter C. Gunter
5465-37	E. W. Jones	
5465-38	Springway Baptist Church	
5465-39	W. B. Sloan	
5465-40	V. C. Adams	
5465-41	Mrs. M. J. Broom	
5465-42	Robert Mote	
5465-43	E. C. Smith	
5465-44	H. J. Crane	
5465-45	I. P. Griffin	
5465-46	C. E. Miller Estate	
5465-47	A. B. Peterson	
5465-48	J. R. Free	
5465-49	W. S. Cain	
5465-49-1	G. B. Smith	
5465-49-2	J. D. Sosebee	
5465-50	W. F. England	
5465-51	Margie Riley and Fletcher Riley	
5465-52	Blue Ridge Resort	
5465-53	Julius M. Hulsey	
5465-54	J. W. Oglesby Estate (White Sulphur Springs)	
5465-55	Paul Smith	
5465-56	E. H. Reynolds	
5465-57	R. J. Ramsey and W. O. Ramsey	
5465-58	M. G. Reynolds	
5465-59	J. C. Harrington	loc # 27
5465-60	L. Pitman	
5465-61	Air Line Baptist Church	
5465-62	Air Line High School	loc # 10, 11 & 17
5465-63	S. I. Baugh	loc # 2
5465-64	Mrs. Grace P. Wilson Estate	
5465-65	Air Line High School	
5465-66	B. J. Hulsey	5465-69-1 H. G. Buffington
5465-67	L. E. Smith	5465-69-2 David P. Hall
5465-68	Jasper M. Hulsey	
5465-69	M. E. Browning	
5465-70	J. W. McCrackin	
	Southern Railway Company (wire crossing)	

RS

Name of Line

Account No.

STATE OF GEORGIA,

EASEMENT Athens Division

Rabbitown-White Sulphur Rural Line
2023-249 - LOE AD-1349

HALL COUNTY.

5465-59

Received of GEORGIA POWER Company, hereinafter called the Company, the sum ofONE & 7/100Dollars (\$ 1.02), in consideration of whichthe undersigned, J. C. HARRINGTON, whose Post Office Address isGAINESVILLE, GA.do ES hereby grant and convey to the said Company, its successors and assigns, the right-of-way upon, along and across all that tract of land owned by the undersigned in Land Lot Number _____ of the GAINESVILLE District, _____ Sectionof HALL County, State of Georgia, said lands being bounded on the Northby lands of M. G. REYNOLDS, on the South by lands ofRAMSEY & NORRIS, on the East by lands of RAMSEY ESTATE_____, and on the West by lands of L. PITMAN;

together with the right, privilege and easement to go in and upon the said tract of land and to construct, operate and maintain perpetually upon said right-of-way its lines for transmitting electric current, with poles, wires and other necessary apparatus and appliances, including the right to stretch telephone and/or telegraph wires on said poles, with all necessary appliances, with the right to permit the attachment of the wires of any other company, or person, to said poles and appliances; together with the right at all times to enter upon said premises for the purpose of inspecting said lines, making repairs, renewals, alterations and extensions thereon, thereto or therefrom; together with the right to cut away and keep clear of said lines all trees and other obstructions that may now or hereafter in any way interfere or be likely to interfere with the proper operation of said lines. Any timber cut on said right-of-way by or for said Company shall remain the property of the owner of said timber.

Said Company shall not be liable for, or bound by, any statement, agreement or understanding not herein expressed.

IN WITNESS WHEREOF, the said J. C. HARRINGTON hashereunto set his hand and seal, this 9th day of Sept., 1937.

Signed, sealed and delivered in the presence of:

J. W. BrowningR. M. FowlesJ. C. Harrington (SEAL)

(SEAL)

(SEAL)

DEED BOOK 77PAGE 227

Gainesville

Amended

Name of Line

LF 6-633

Account No.

5465-62

STATE OF GEORGIA,

EASEMENT

Athens Division

Hobittown-White Sulphur Rural Line
2003-249 - LCE AD-1349

HALL COUNTY.

Received of GEORGIA POWER

Company, hereinafter called the Company, the sum of

ONE \$ 100.00

Dollars (\$ 100.00), in consideration of which

the undersigned, AIR LINE HIGH SCHOOL, whose Post Office Address is

(Name)

GAINESVILLE, GA. RT. 6, do hereby grant and convey to the said Company, its successors and

assigns, the right-of-way upon, along and across all that tract of land owned by the undersigned in Land Lot

Number of the GLADE District, Section

of HALL County, State of Georgia, said lands being bounded on the North

by lands of B. J. HULSEY & MRS. GRACE WILSON, on the South by lands of

Cemetery & L. P. PITMAN, on the East by lands of B. J. HULSEY

and on the West by lands of S. T. BAUGH;

together with the right, privilege and easement to go in and upon the said tract of land and to construct, operate and maintain perpetually upon said right-of-way its lines for transmitting electric current, with poles, wires and other necessary apparatus and appliances, including the right to stretch telephone and/or telegraph wires on said poles, with all necessary appliances, with the right to permit the attachment of the wires of any other company, or person, to said poles and appliances; together with the right at all times to enter upon said premises for the purpose of inspecting said lines, making repairs, renewals, alterations and extensions thereon, thereto or therefrom; together with the right to cut away and keep clear of said lines all trees and other obstructions that may now or hereafter in any way interfere or be likely to interfere with the proper operation of said lines. Any timber cut on said right-of-way by or for said Company shall remain the property of the owner of said timber.

ALSO THE RIGHT TO ~~BE~~ CONSTRUCT A POLE WITH WIRES
ETC., ON THE DOMINORY PROPERTY IN THE CITY OF WHITE SULPHUR.

Said Company shall not be liable for, or bound by, any statement, agreement or understanding not herein expressed.

IN WITNESS WHEREOF, the said AIR LINE HIGH SCHOOL have

hereunto set THEIR hand and seal, this SEPT. day of 1937.

Signed, sealed and delivered in the presence of:

[Signature]
A. M. FORD

AIR LINE HIGH SCHOOL (SEAL)

By W. O. Ramsey (SEAL)

By John L. Harrington (SEAL) Chairman

By *[Signature]*

DEED BOOK 77

PAGE 218

This easement to be signed in the presence of two (2) witnesses, one of whom should be a Notary Public.

SEQ. NO. 29-854

Form 2-1-1 10M 7-22-36

Name of Line Gainesville
Account No. LF 6-635

EASEMENT

STATE OF GEORGIA,

Attest Division
Baltimore-White Sulphur Rural Line
2027-2028 - 105 AD-1349

5465-61

HALL COUNTY.

Received of GEORGIA POWER Company, hereinafter called the Company, the sum of ONE & 07/100 Dollars (\$ 1.07), in consideration of which the undersigned, AIR LINE BAPTIST CHURCH (Name), whose Post Office Address is GAINESVILLE, GA-RT-6, do hereby grant and convey to the said Company, its successors and assigns, the right-of-way upon, along and across all that tract of land owned by the undersigned in Land Lot Number _____ of the GLADE District, _____ Section of HALL County, State of Georgia, said lands being bounded on the North by lands of AIR LINE HIGH SCHOOL, on the South by lands of M. G. REYNOLDS, on the East by lands of M. G. REYNOLDS, and on the West by lands of L. PITMAN;

together with the right, privilege and easement to go in and upon the said tract of land and to construct, operate and maintain perpetually upon said right-of-way its lines for transmitting electric current, with poles, wires and other necessary apparatus and appliances, including the right to stretch telephone and/or telegraph wires on said poles, with all necessary appliances, with the right to permit the attachment of the wires of any other company, or person, to said poles and appliances; together with the right at all times to enter upon said premises for the purpose of inspecting said lines, making repairs, renewals, alterations and extensions thereon, thereto or therefrom; together with the right to cut away and keep clear of said lines all trees and other obstructions that may now or hereafter in any way interfere or be likely to interfere with the proper operation of said lines. Any timber cut on said right-of-way by or for said Company shall remain the property of the owner of said timber.

Said Company shall not be liable for, or bound by, any statement, agreement or understanding not herein expressed.

IN WITNESS WHEREOF, the said AIR LINE BAPTIST CHURCH have hereunto set THEIR hand and seal, this SEPT day of 1937.

Signed, sealed and delivered in the presence of:

O. B. Williams
A. M. Jones

AIR LINE BAPTIST CHURCH (SEAL)
By J. W. Browning (SEAL)
By John L. Harington (SEAL)
By Julius M. Hulse

DEED BOOK 77
217

This easement to be signed in the presence of two (2) witnesses, one of whom should be a Notary Public.

SEQ. NO.

19-849

Name of Line

Account No.

Athens Division

Rabbittown-White Sulphur Rural Line
2023-240 - 10E 40-1340

EASEMENT

STATE OF GEORGIA,

HALL COUNTY.

5465-58

Received of GEORGIA POWER Company, hereinafter called the Company, the sum of ONE & 00/100 Dollars (\$ 1.00), in consideration of which the undersigned, M. G. REYNOLDS, whose Post Office Address is GAINESVILLE, GA-RT-6, does hereby grant and convey to the said Company, its successors and assigns, the right-of-way upon, along and across all that tract of land owned by the undersigned in Land Lot Number _____ of the GLADE District, _____ Section of HALL County, State of Georgia, said lands being bounded on the North by lands of AIR LINE CHURCH PROP., on the South by lands of MRS. JOE RAMSEY, on the East by lands of J. M. HULSEY, and on the West by lands of JOHN HARRINGTON;

together with the right, privilege and easement to go in and upon the said tract of land and to construct, operate and maintain perpetually upon said right-of-way its lines for transmitting electric current, with poles, wires and other necessary apparatus and appliances, including the right to stretch telephone and/or telegraph wires on said poles, with all necessary appliances, with the right to permit the attachment of the wires of any other company, or person, to said poles and appliances; together with the right at all times to enter upon said premises for the purpose of inspecting said lines, making repairs, renewals, alterations and extensions thereon, thereto or therefrom; together with the right to cut away and keep clear of said lines all trees and other obstructions that may now or hereafter in any way interfere or be likely to interfere with the proper operation of said lines. Any timber cut on said right-of-way by or for said Company shall remain the property of the owner of said timber.

THE COMPANY AGREES TO SHIFT SAID LINE, IF SAME INTERFERES WITH ANY DWELLING THAT MR. REYNOLDS MAY BUILD ON THE SOUTH WEST CORNER OF SAID PROPERTY.

Said Company shall not be liable for, or bound by, any statement, agreement or understanding not herein expressed.


IN WITNESS WHEREOF, the said M. G. REYNOLDS has hereunto set his hand and seal, this 24 day of SEPT., 1937.

M. G. Reynolds (SEAL)
(SEAL)
(SEAL)


Signed, sealed and delivered in the presence of:

Kimmy Marling
A. M. Goudy


DEED BOOK 77
PAGE 242

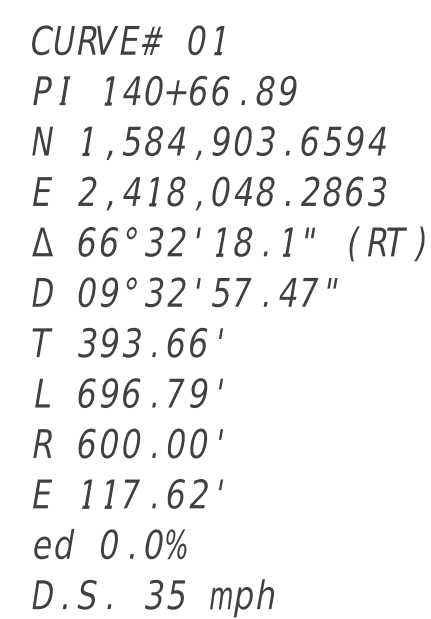

CHECKED:	DATE:	DRAWING No. 24-0001
BACKCHECKED:	DATE:	
CORRECTED:	DATE:	
VERIFIED:	DATE:	

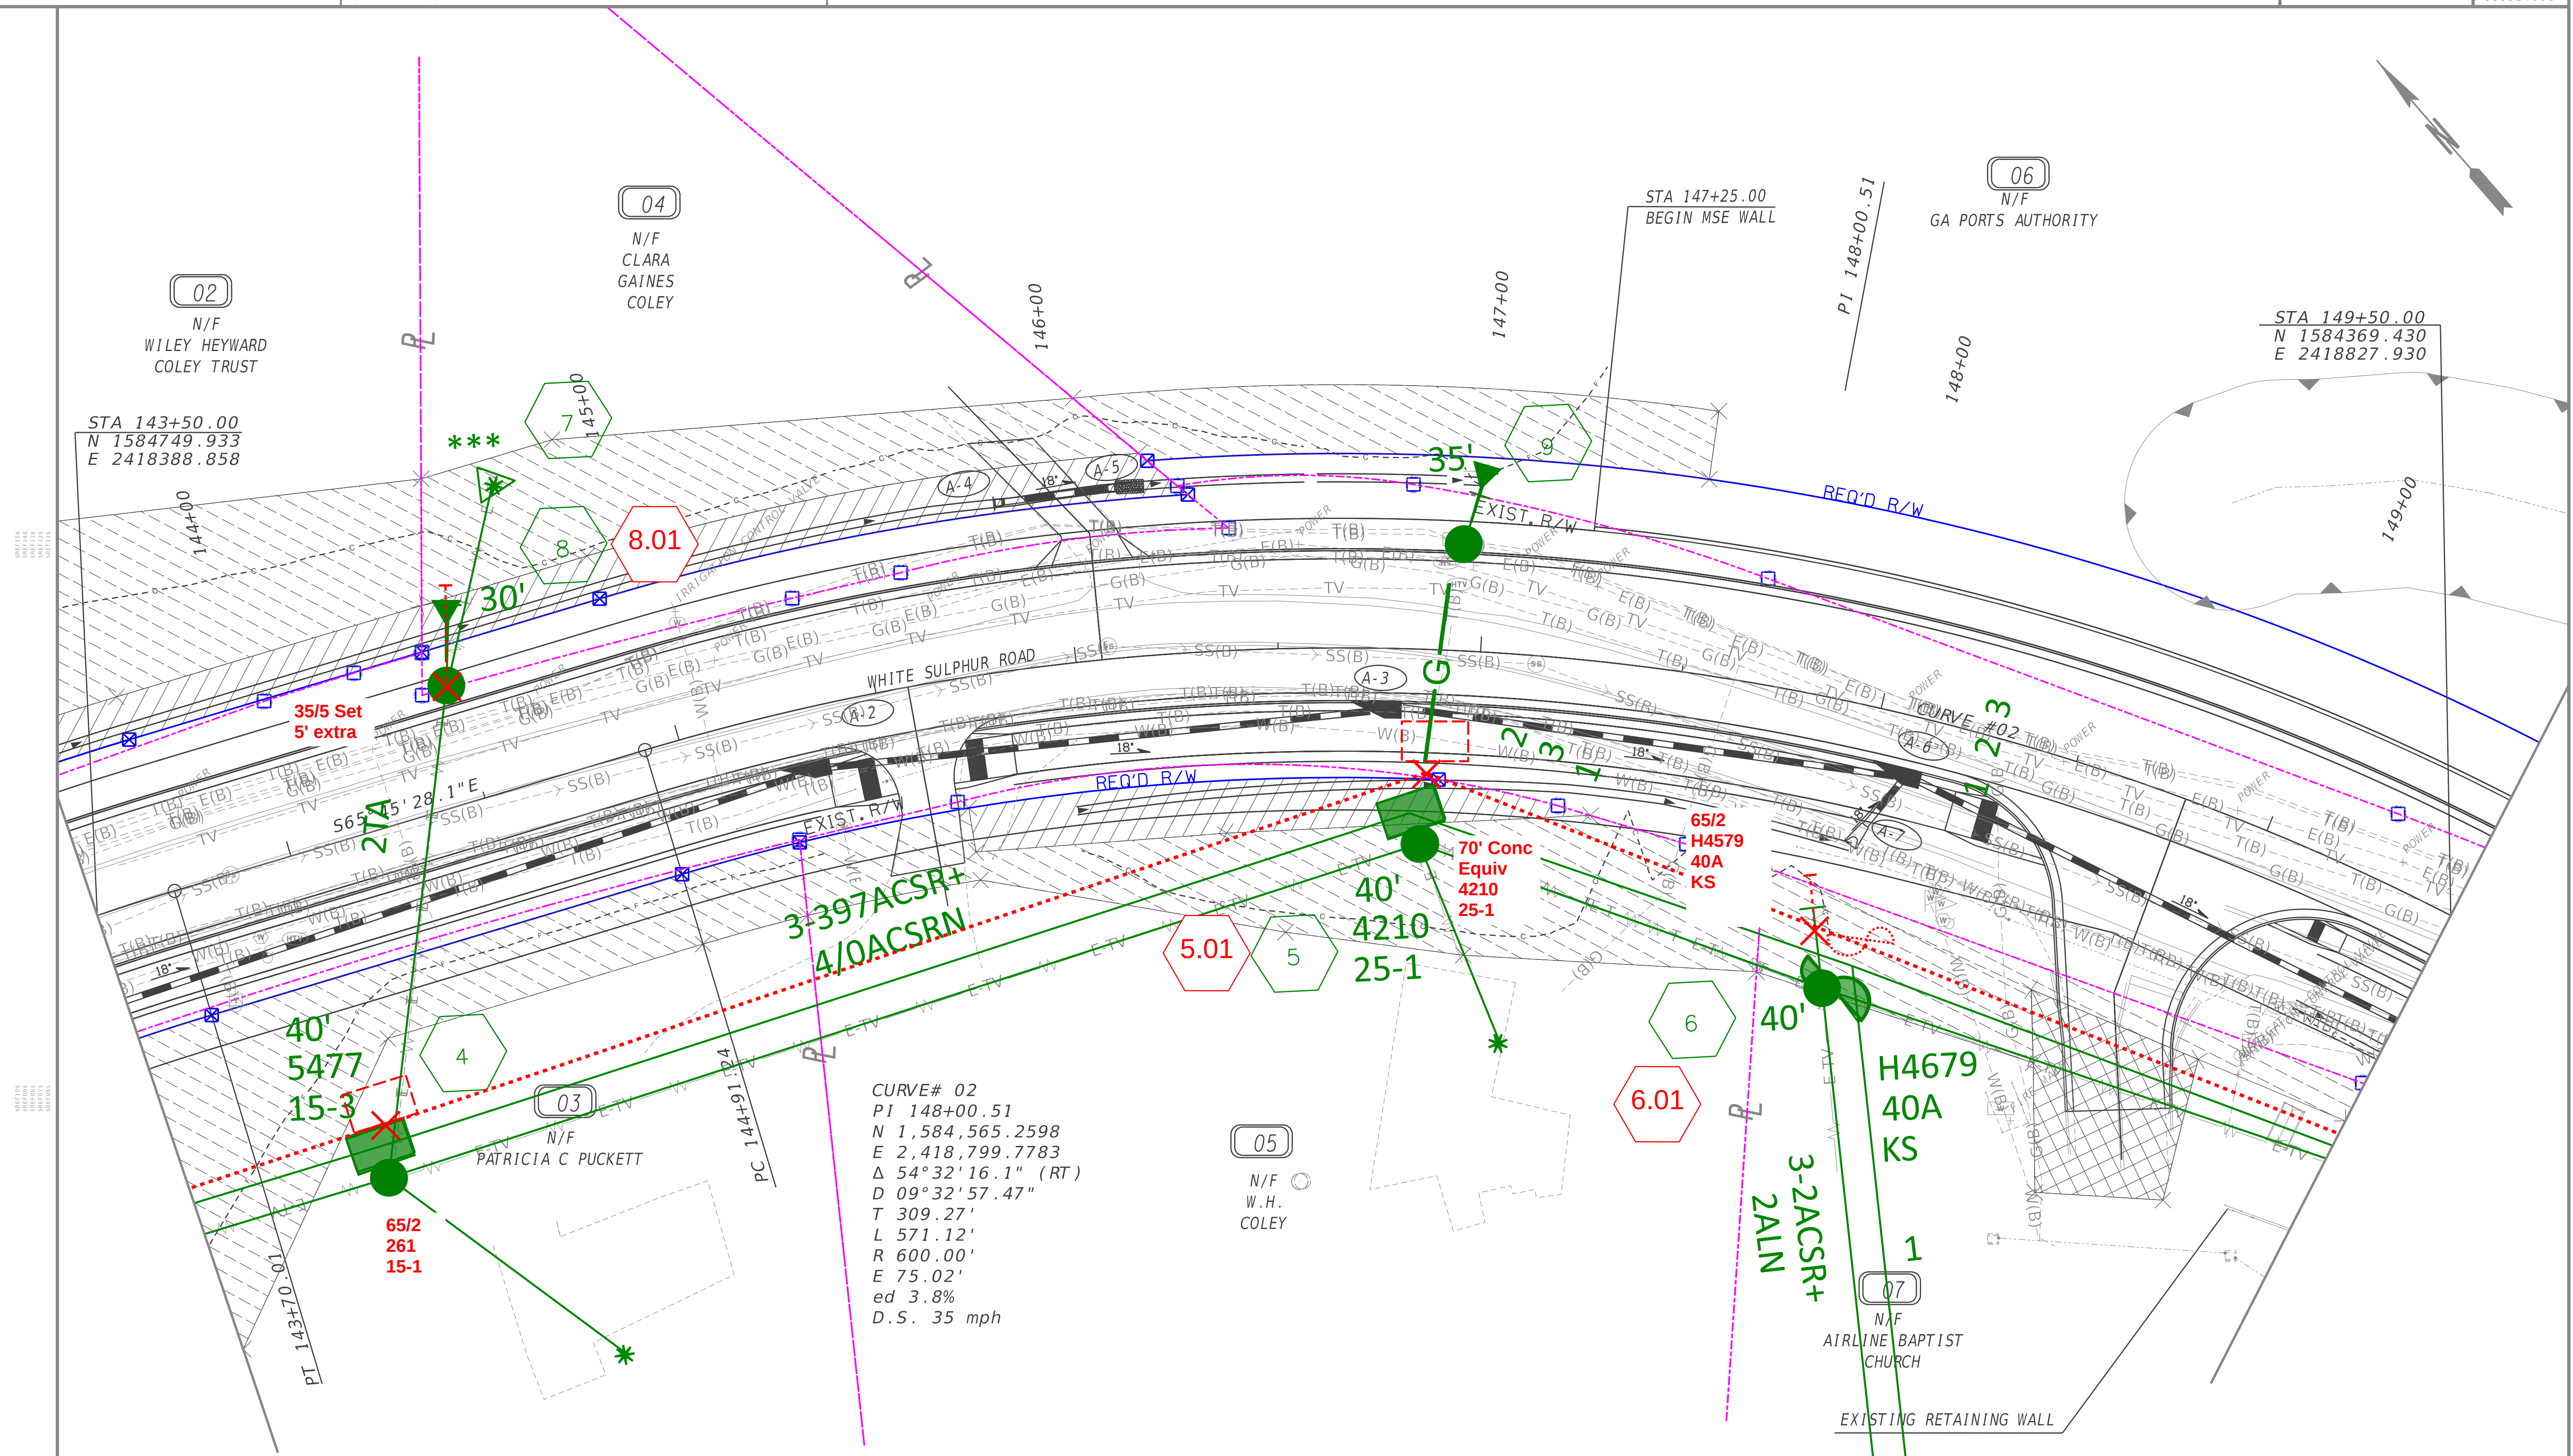

UTILITY PLANS			
WHITE SULPHUR ROAD AT SR 365			
WIDENING AND INTERSECTION IMPROVEMENT			
CHECKED:		DATE:	
BACKCHECKED:		DATE:	
CORRECTED:		DATE:	
VERIFIED:		DATE:	
			DRAWING No. 24-0002

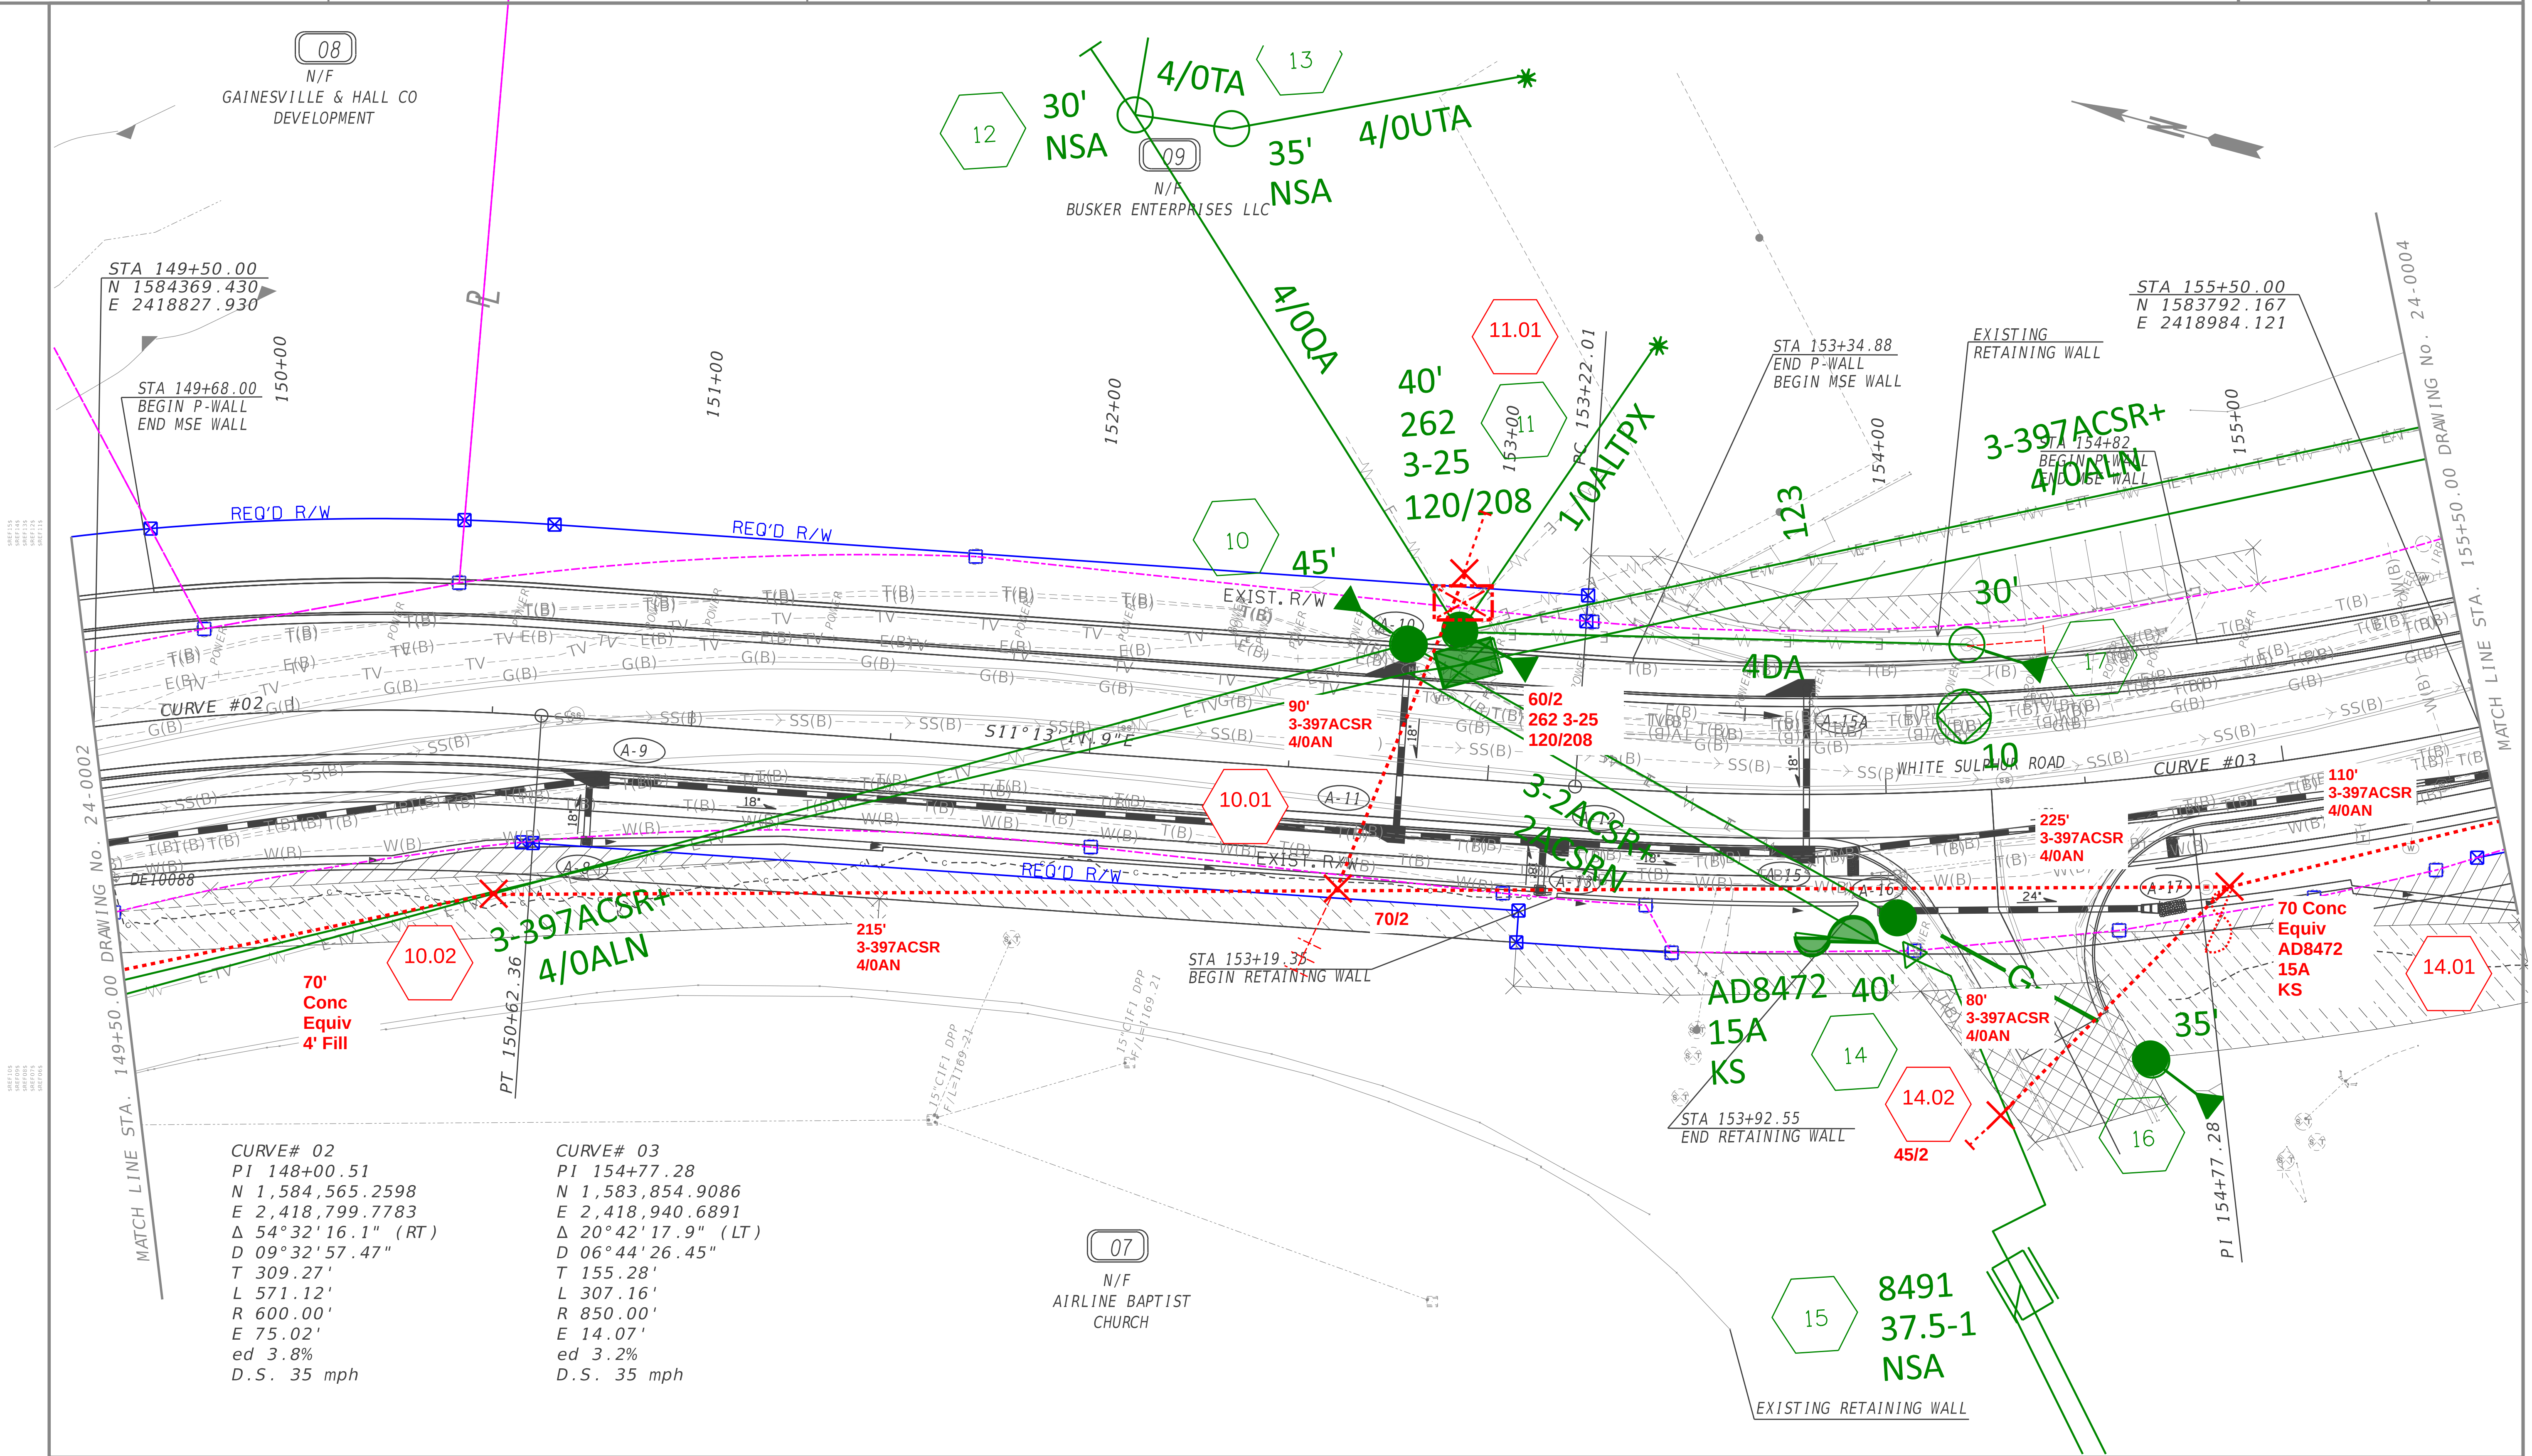

PROPERTY AND EXISTING R/W LINE
REQUIRED R/W LINE
CONSTRUCTION LIMITS
EASEMENT FOR CONSTR
& MAINTENANCE OF SLOPES
EASEMENT FOR CONSTR OF SLOPES
EASEMENT FOR CONSTR OF DRIVES

BEGIN LIMIT OF ACCESS.....BLA
END LIMIT OF ACCESS.....ELA
EXISTING LIMIT OF ACCESS
REQ'D LIMIT OF ACCESS
EXISTING LIMIT OF ACCESS & R/W
REQ'D LIMIT OF ACCESS & R/W
ORANGE BARRIER FENCE
ESA - ENV. SENSITIVE AREA

ATLAS

2450 Commerce Avenue
Suite 100
Duluth, Georgia 30096
770.263.5945

SCALE IN FEET

0

20

40

80

REVISION DATES


UTILITY PLANS
WHITE SULPHUR ROAD AT SR 365
WIDENING AND INTERSECTION IMPROVEMENT

CHECKED:
BACKCHECKED:
CORRECTED:
VERIFIED:

DATE:
DATE:
DATE:
DATE:

DRAWING No.
24-0003


GPLN-CE
11/05/2020

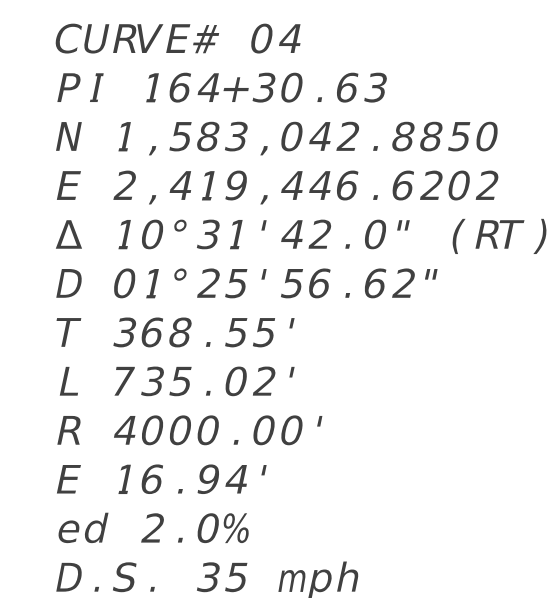


UTILITY PLANS			
WHITE SULPHUR ROAD AT SR 365			
WIDENING AND INTERSECTION IMPROVEMENT			
CHECKED:		DATE:	DRAWING No. 24-0004
BACKCHECKED:		DATE:	
CORRECTED:		DATE:	
VERIFIED:		DATE:	



HALL COUNTY
GEORGIA

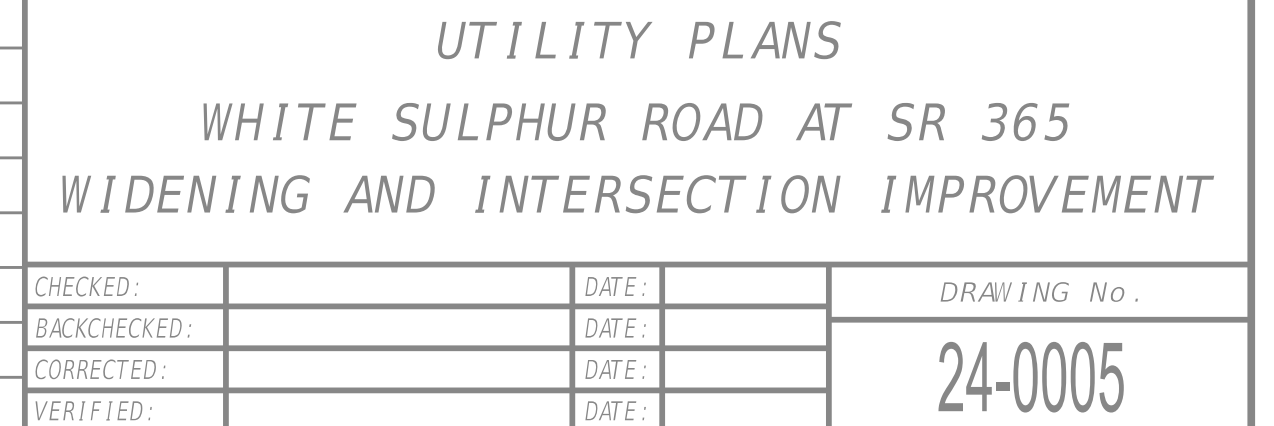

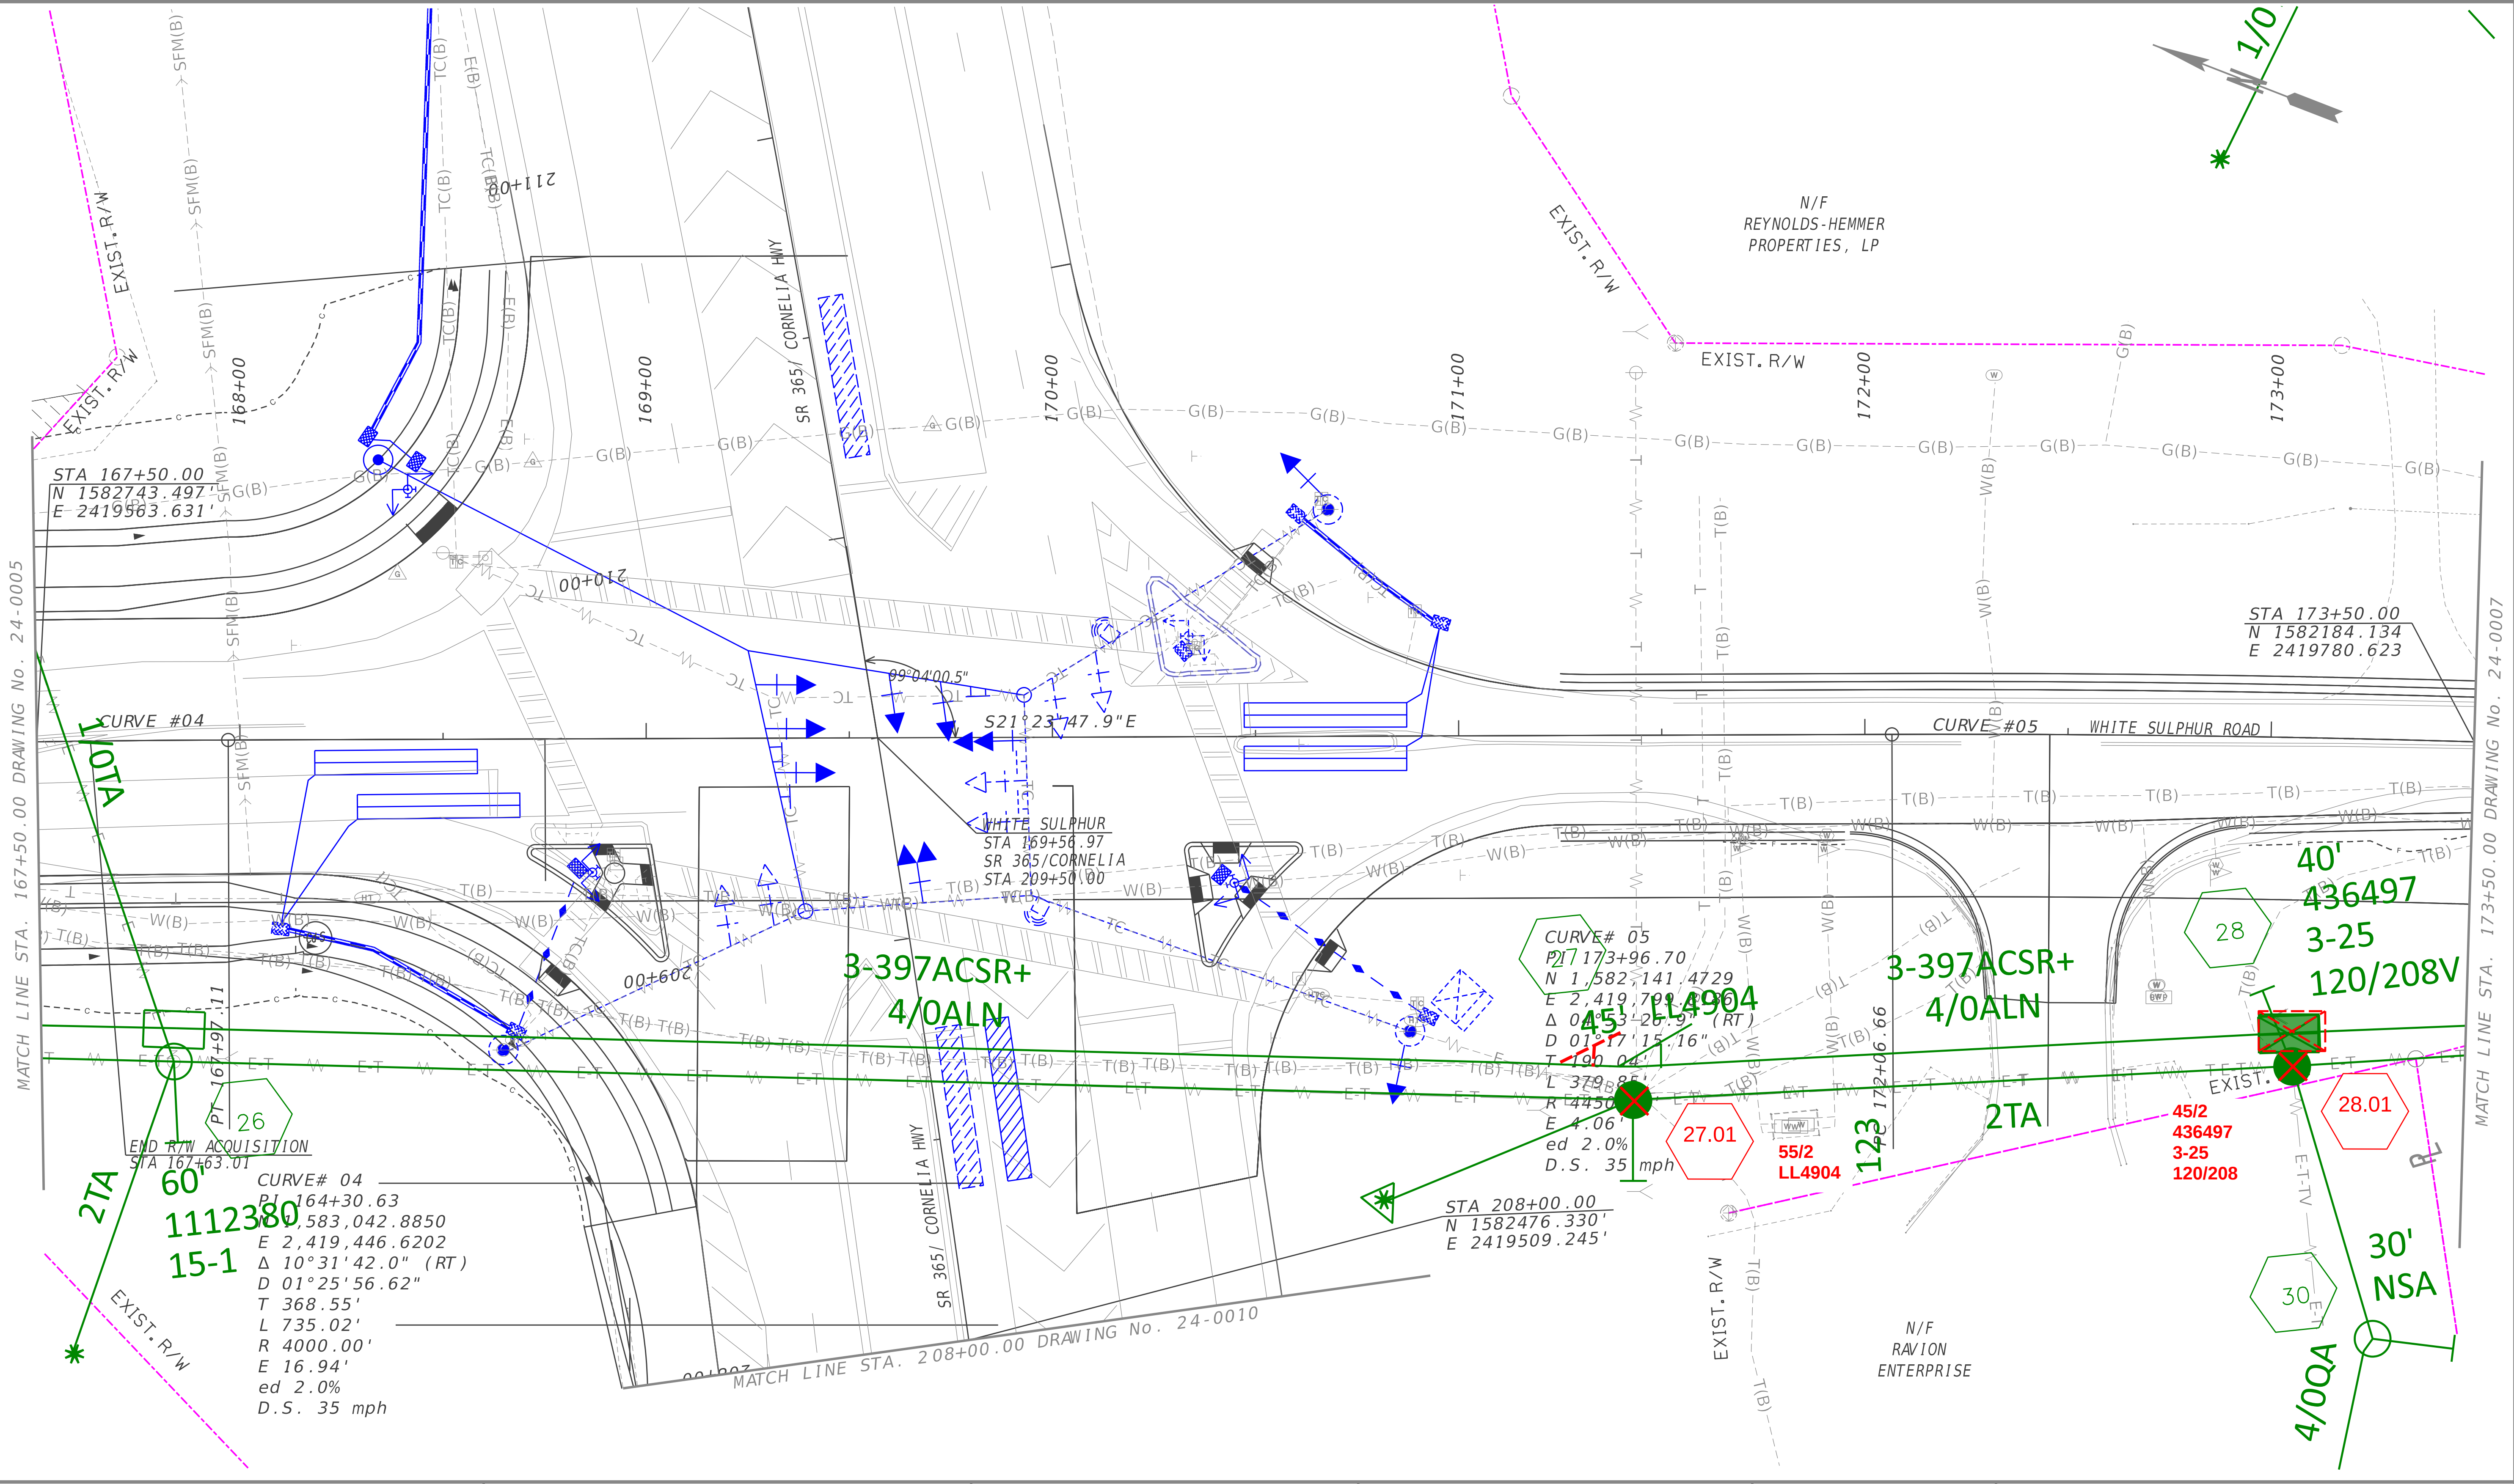

PROPERTY AND EXISTING R/W LINE
REQUIRED R/W LINE
CONSTRUCTION LIMITS
EASEMENT FOR CONSTR
& MAINTENANCE OF SLOPES
EASEMENT FOR CONSTR OF SLOPES
EASEMENT FOR CONSTR OF DRIVES

-----#-----

-----C-----

BEGIN LIMIT OF ACCESS.....BLA

END LIMIT OF ACCESS.....ELA

EXISTING LIMIT OF ACCESS

REQ'D LIMIT OF ACCESS

EXISTING LIMIT OF ACCESS & R/W

REQ'D LIMIT OF ACCESS & R/W

ORANGE BARRIER FENCE

ESA - ENV. SENSITIVE AREA

ATLAS

2450 Commerce Avenue
Suite 100
Duluth, Georgia 30096
770.263.5945

SCALE IN FEET

0

20

40

80

REVISION DATES

UTILITY PLANS

WHITE SULPHUR ROAD AT SR 365

WIDENING AND INTERSECTION IMPROVEMENT

CHECKED:

BACKCHECKED:

CORRECTED:

VERIFIED:

DATE:

DATE:


DATE:

DATE:

DRAWING No.

24-0006

GPLN-CE
11/05/2020

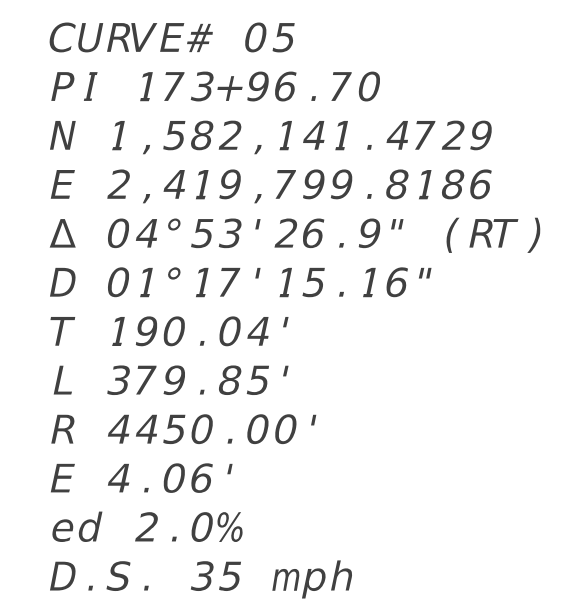

HALL COUNTY
GEORGIA

[illegible]

UTILITY PLANS			
WHITE SULPHUR ROAD AT SR 365			
WIDENING AND INTERSECTION IMPROVEMENT			
CHECKED:		DATE:	DRAWING No.
BACKCHECKED:		DATE:	
CORRECTED:		DATE:	
VERIFIED:		DATE:	24-0007